

NOTE: METRIC DIMENSIONS ARE IN PARENTHESES AND ARE EXPRESSED IN MILLIMETERS

THERMALLOY SPECIFICATION CONTROL DRAWING
SOCKETS, LAMINATED - MOUNTING

035075

REVISION RECORD			
ECN NO.	CUSTOMER REV	AAVID REV	DATE
11776	J	A	3-22-01

035075

J	DELETIONS	8/2/85	7887	KM	DLB
SYM	REVISION RECORD	DATE	ECN	DRAWN	CHECKED
		Thermalloy Inc.			
TITLE A SOCKETS, LAMINATED-MOUNTING				SCALE NONE DO NOT SCALE	
DRAWN S. JOHNSON		DATE 5-8-75		SIZE A	MATERIAL
CHECKED S. JOHNSON		DATE 5-8-75		TYPE SD	SEE 2.0
APPROVED		DATE		CODE IDENT NO. 13103	
TOLERANCES +.015 (.38) +1° EXCEPT AS NOTED		ORIGINATING ECM 2655		DRAWING NUMBER 11692 THRU 11695	
				REV J	

NOTE: METRIC DIMENSIONS ARE IN PARENTHESES AND ARE EXPRESSED IN MILLIMETERS

- 1.0 SCOPE: THIS DOCUMENT DETAILS THE REQUIREMENTS FOR LAMINATED MOUNTING SOCKETS.
- 2.0 MATERIAL:
- 2.1 TOP PLATE: MOLDED NYLON PER MIL-P-20693A
- 2.2 BASE: PHENOLIC PBE GRADE, COLOR: NATURAL
- 2.3 COLLECTOR PLATE: STEEL, ~~CAD PLATE~~ ZINC II PLATE P.D.
- 2.4 CONTACTS: .012 THICK BRASS. ~~CAD PLATE~~ ZINC II PLATE P.D.
- 3.0 REQUIREMENTS:
- 3.1 SOLDERABILITY: SOLDERABLE PER EIA SOLDERABILITY SPEC RS-186-9E
- 4.0 PRECEDENCE:
- 4.1 IN THE EVENT OF CONFLICT, THE ORDER OF PRECEDENCE FOR RELATED DOCUMENTS SHALL BE AS FOLLOWS:
- A. THIS DOCUMENT
- B. OTHER SPECIFICATIONS
- 5.0 CONFIGURATION:
- 5.1 DIMENSIONAL REQUIREMENTS: SEE TABLE "A"
- 5.2 METRIC DIMENSIONS ARE IN PARENTHESES AND ARE EXPRESSED IN MILLIMETERS.
- 5.3 TOLERANCES ON NOTED DIMENSIONS TO BE $\pm .010$ (.25).

SEE SHEET 1

035075

SYM	REVISION RECORD	DATE	ECN	DRAWN	CHECKED
 Thermalloy[*] Inc.					SCALE
					NONE DO NOT SCALE
DRAWN S. JOHNSON DATE 5-8-75			SIZE A	MATERIAL	
CHECKED S. JOHNSON DATE 5-8-75			TYPE SD	SEE 2.0	
APPROVED			DATE	CODE IDENT NO. 13103	
TOLERANCES		ORIGINATING ECM	DRAWING NUMBER		REV
$\pm .015$ (.38) $\pm 1^\circ$ EXCEPT AS NOTED		2655	11692 THRU 11695		J

SHEET 2 OF 5

TABLE "A"

THERMALLOY		(OLD)	EEI P/N	COLOR	FIGURE	CONFIGURATION
PART #	CAT. NO.	KEYSTONE P/N				
11692	8114 LB 603	4602	1001-2	BLUE	1	TO-3 DIAMOND 035075
11693	8116 LB 603	4608	1004-2	NATURAL	2	TO-3 SQUARE
11694	8115 LB 666	4612	1011-2-A	GREEN	3	TO-66 DIAMOND
11695	8117 LB 466	4625	1012-1	RED	4	TO-66 SQUARE

SEE SHEET 1

035075

SYM	REVISION RECORD	DATE	ECN	DRAWN	CHECKED
 Thermalloy[*] Inc.					
TITLE SOCKETS, LAMINATED - MOUNTING					SCALE NONE DO NOT SCALE
DRAWN S. JOHNSON		DATE 5-8-75		SIZE A	MATERIAL
CHECKED S. JOHNSON		DATE 5-8-75		TYPE SD	SEE 2.0
APPROVED		DATE		CODE IDENT NO. 13103	
EXCEPT AS NOTED DIMENSIONS ARE IN INCHES TOLERANCES: $\pm .015$ (.38) $\pm .10$		ORIGINATING ECN 2655		DRAWING NUMBER 11692 thru 11695	
					REV J

SHEET 3 OF 5

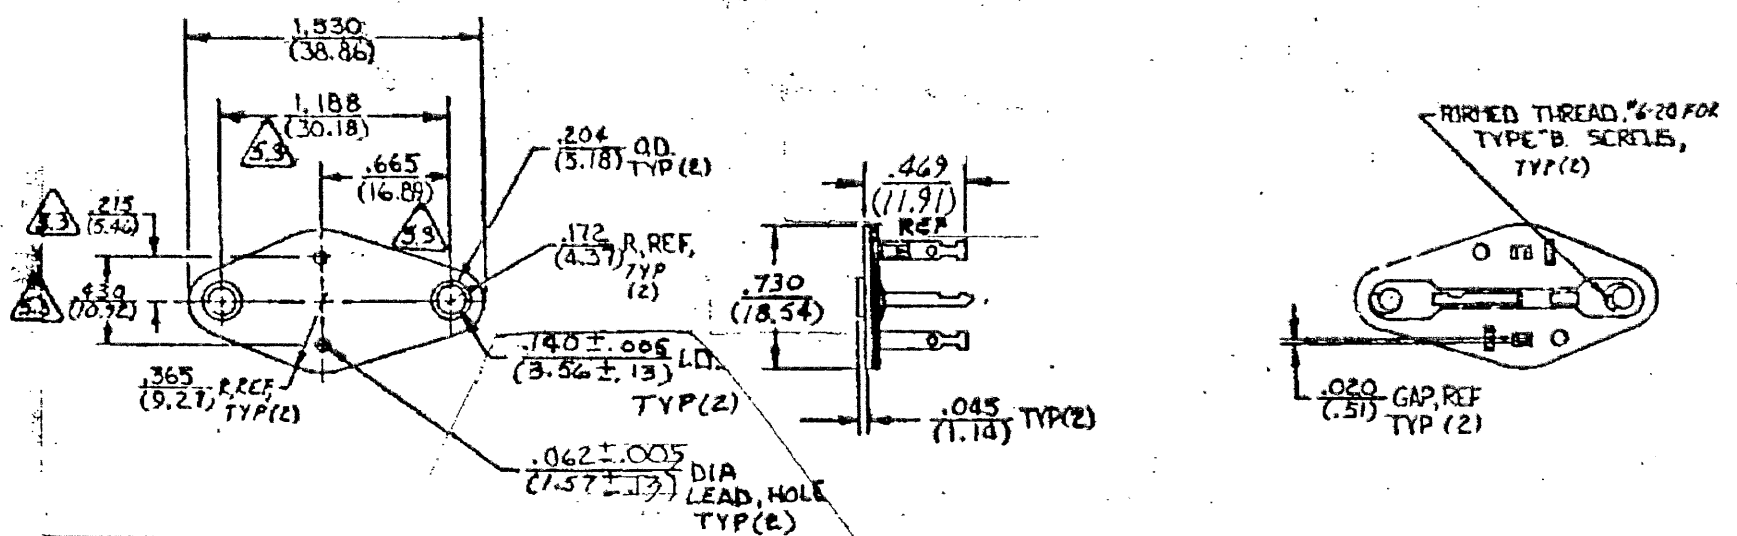


FIGURE 1

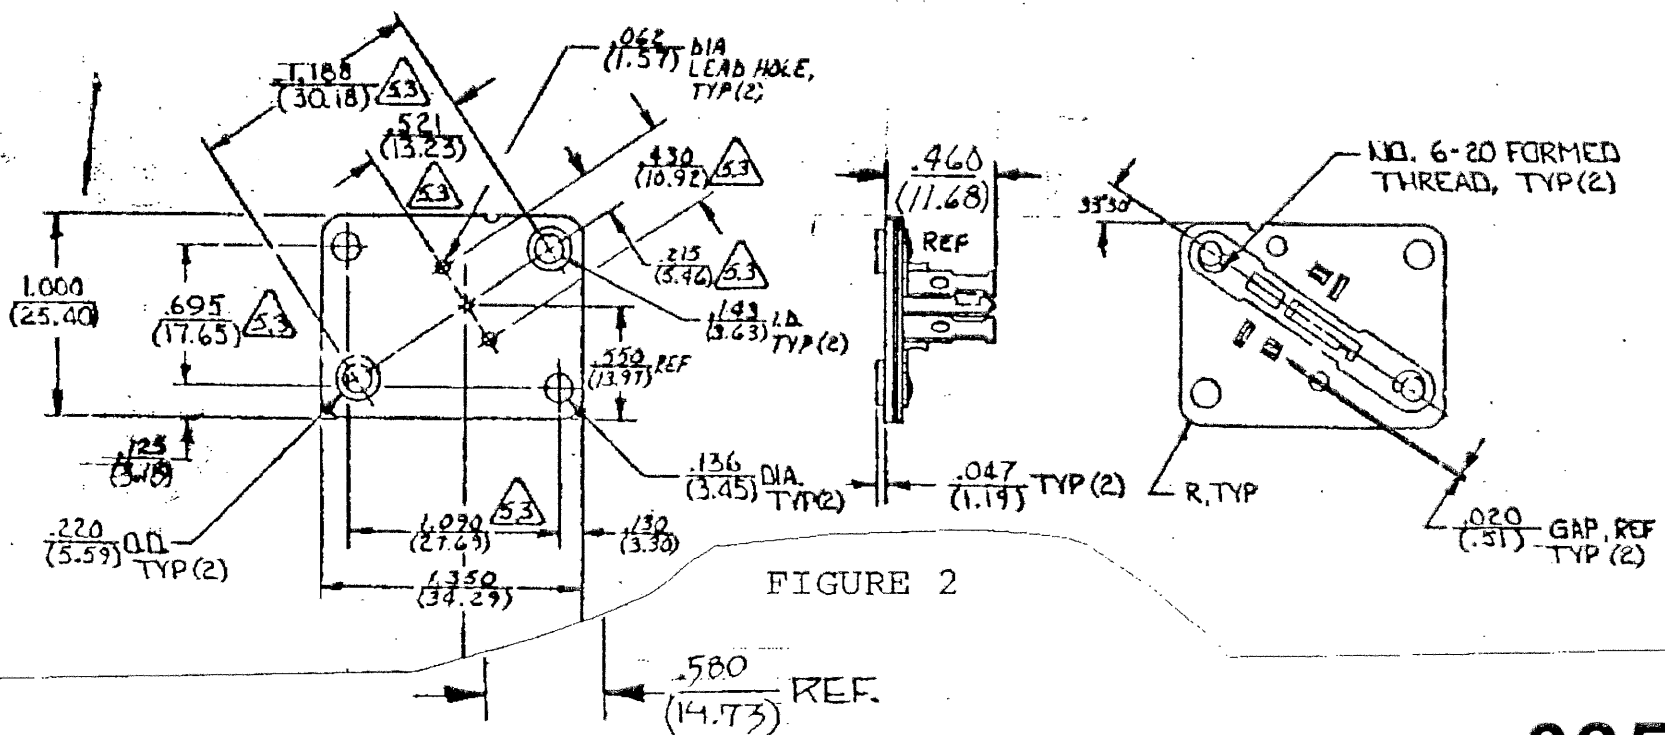


FIGURE 2

SEE SHEET 1

035075

SYM	REVISION RECORD	DATE	ECN	DRAWN	CHECKED
T Thermalloy Company					
TITLE					SCALE
SOCKETS, LAMINATED - MOUNTING					NONE DO NOT SCALE
DRAWN <i>L. Johnson</i> DATE 5-8-75			MATERIAL		
CHECKED <i>L. Johnson</i> DATE 5-8-75			SEE 2.0		
APPROVED			DATE		
EXCEPT AS NOTED DIMENSIONS ARE IN INCHES TOLERANCES $\pm .015$ (.38) $\pm 1^0$			ORIGINATING ECN OR ENGINEERING ORDER 2655		
SIZE A		TYPE SD		REV	
DRAWING NUMBER		11692 thru 11695		J	

